


**R10 SPRAY FOAM UNDER SLAB**  
 FINISHED STONE HEIGHT TO BE 1-3/4" BELOW TOP OF FOOTING

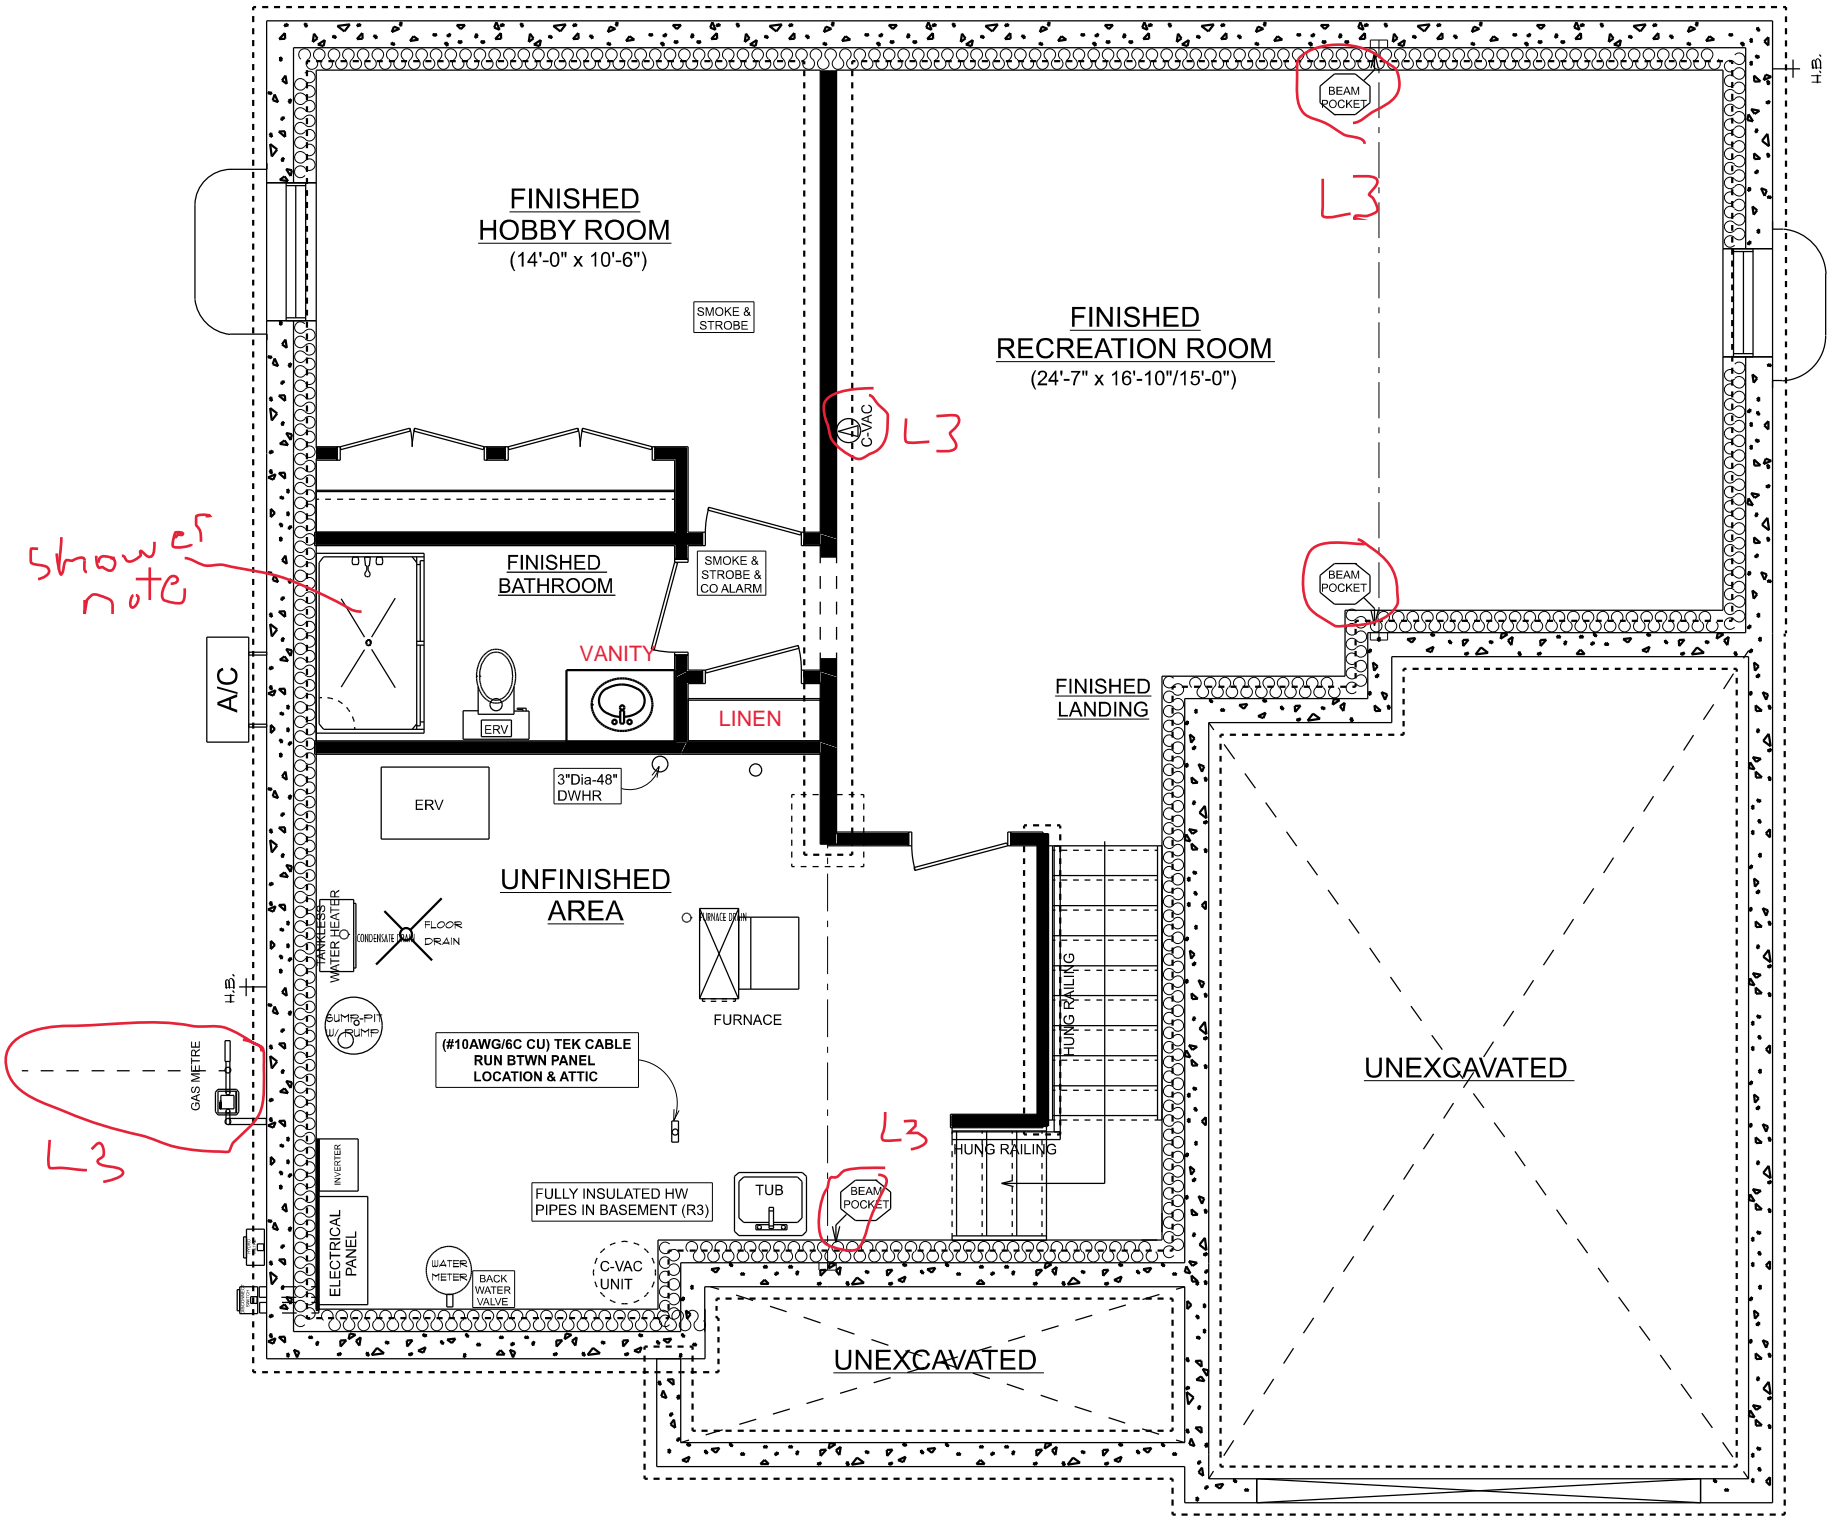

**THE KNOLLWOOD 'A'**  
**BASEMENT PLAN**  
 687 SQ.FT. FINISHED BASEMENT SPACE


Project:	LOT 50 WHITE TAIL (MUN. #40)
Location:	ST. THOMAS, ONTARIO
Plan:	THE KNOLLWOOD 'A'
Scale:	3/16" = 1'-0"
Drawn:	T. TRAVIS
Job No:	50 - ER1
Date:	12/07/2021
Ref #:	Revised Agmt



VENDOR NOT REQUIRED TO ADJUST FOR ANY DISCREPANCIES BETWEEN THIS PLAN AND THE HOME AS BUILT. CHANGES OCCUR DURING CONSTRUCTION.

**DOUG TARRY**  
 CUSTOM HOMES LTD.  
 COPYRIGHT 2021  
 DOUG. TARRY LTD.  
 BUILDERS & DEVELOPERS  
 358 ELM STREET  
 ST. THOMAS ON. N5R 1K1  
 TEL. (519)-631-9300  
 FAX. (519)-631-3583

NOTE: DO NOT SCALE DRAWINGS. USE DIMENSIONS SHOWN ON PLANS. REPORT ANY DISCREPANCIES OR UNCLEAR DIMENSIONS TO THE DESIGN DEPARTMENT.

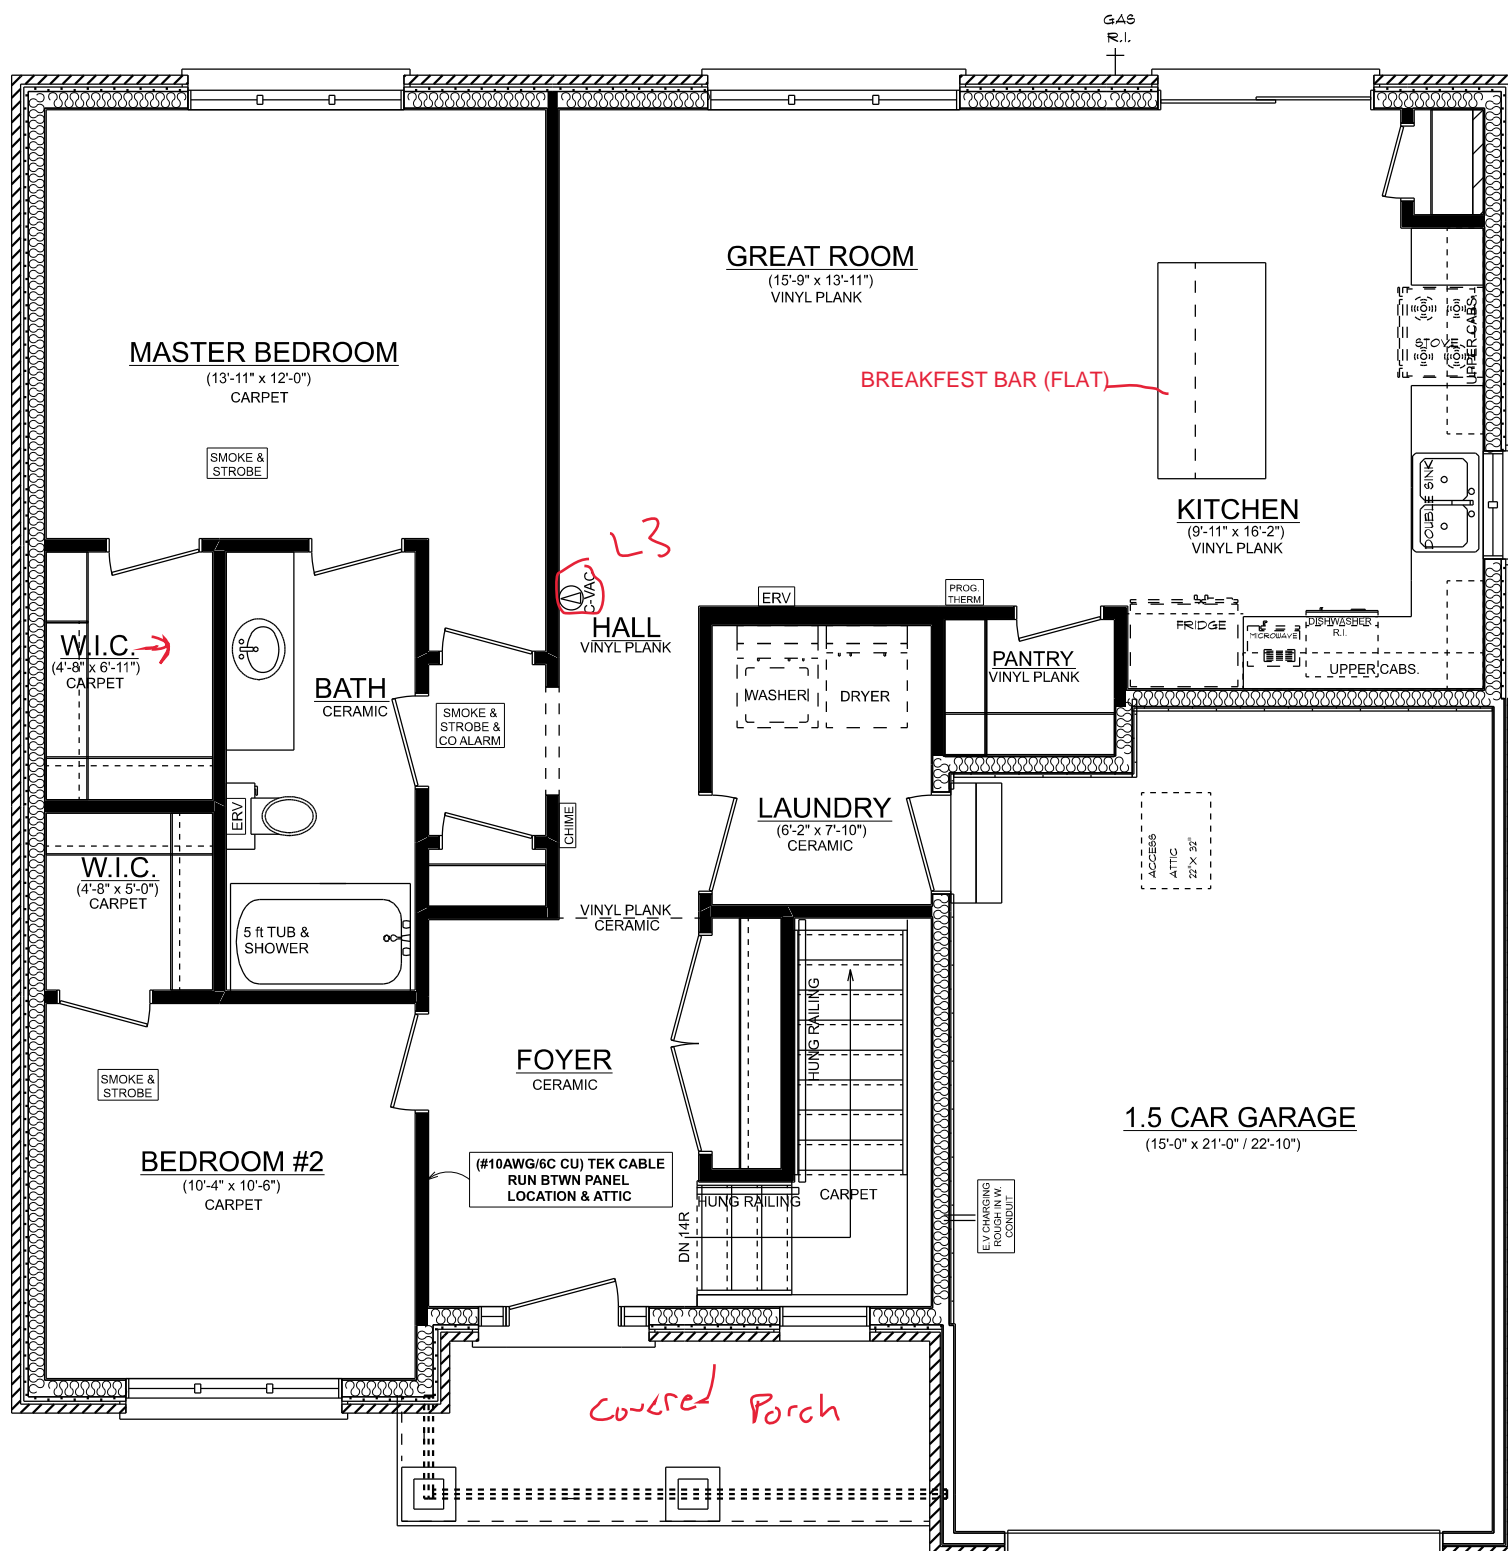

# THE KNOLLWOOD 'A'

## MAINFLOOR PLAN

1226 SQ. FT.  
8' CEILINGS ON MAINFLOOR

Project:	LOT 50 WHITE TAIL (MUN. #40)
Location:	ST. THOMAS, ONTARIO
Plan:	THE KNOLLWOOD 'A'
Scale:	3/16" = 1'-0"
Drawn:	T. TRAVIS
Job No:	50 - ER1
Date:	12/07/2021
Ref #:	Revised Agmt



VENDOR NOT REQUIRED TO ADJUST FOR ANY DISCREPANCIES BETWEEN THIS PLAN AND THE HOME AS BUILT. CHANGES OCCUR DURING CONSTRUCTION.



COPYRIGHT 2021  
DOUG. TARRY LTD.  
BUILDERS & DEVELOPERS  
358 ELM STREET  
ST. THOMAS ON. N5R 1K1  
TEL. (519)-631-9300  
FAX.(519)-631-3583

NOTE: DO NOT SCALE DRAWINGS. USE DIMENSIONS SHOWN ON PLANS. REPORT ANY DISCREPANCIES OR UNCLEAR DIMENSIONS TO THE DESIGN DEPARTMENT.